

S P T

Work Order ID 146207 - /

May 11, 2016 12:39:15 PM



146207



Page 1

Item ID: D3695-3

Accept

Revision ID:

N900040100

Setup Start *NS1*

Item Name: Stopper

Stop *NS2*

Start Date: 5/20/2016 Start Qty: 10.00

10

Required Date: 6/10/2016 Req'd Qty: 10.00

10

Cust Item ID:

Reference:

Customer:

Approvals:

Process Plan: SH

Date: 01605 Tooling:

Date:

Run Start *NR1*

QC:

Date:

SPC (Y/N):

Date:

Stop *NR2*

Sequence ID/ Work Center ID	Operation Description	Set Up/ Run Hours	Tool ID	Tool #	Plan Code	Accept Qty	Reject Qty	Reject Number	Insp. Stamp
--------------------------------	--------------------------	----------------------	---------	--------	--------------	---------------	---------------	------------------	----------------

Draw Nbr

Revision Nbr

D3695

Rev E

100

100

BAND SAW

0.00

Bandsaw

Memo

0.00

Jeaspa Bandsaw

Cut blank 4.25 " long

DAS

44

9-89

16-05-17

110

110

HAAS CNC VERTICAL MACHINING #1

0.00

HAAS 1

Memo

0.00

HAAS CNC vertical machine #1

1- Mill as per Folio FA733 Rev: C & Dwg D3695 Rev: E
2-Deburr per dwg D3695
3-TAP FOR 3/8"-24 HELICOIL

DAS

44

9-89

16-05-18

16/05/20

120

120

QC2- Inspect parts off machine FAI/FAIB

0.00

QC

Memo

0.00

Quality Control

DAS

44

9-89

16-05-18

DQA:

Date: 16.08.09



QA Closed:

Date: 16-08-08

WORK ORDER NON-CONFORMANCE / UPDATE

Work Order update only ☐

Work Order: 146207-1		DISPOSITION		AGAINST DEPARTMENT/PROCESS							
Part No. D3695-3		Rework ☐		Skid-tube ☐		Cross tube ☐		Water Jet ☐		Engineering ☐	
NCR No. 16-5951		Scrap ☐		Machining ☒		Small Fab ☐		Prod. Eng. Coord. ☐		Quality ☐	
		Use-as-is ☒		Thermoforming ☐		Finishing ☐		Rec/Store/Packaging ☐		Other ☐	
		Suspected Unapproved ☐		Large Fab ☐		Composite ☐		Supplier ☐			
Date: 16/05/30		Step #: 110		QTY Effective: 3				MRB (QSI042) Approval DAS 9 9-89			
Description Work Order Deviation				Disposition							
1 part, the thread was off axis. 2 part the holes was off by .004" over tolerance.				test fit Test fit successful. DAS 12 9-89 16/7/17				Completed By 38 9-89 JUN 07 2016 Lead hand / Supervisor Approval Verification DAS 14 9-89 16/05/30 QC / QA Coordinator Approval DAS 38 9-89 JUN 07 2016			
Root Cause				FAULT CATEGORY							
Environment ☐ Design ☐ Doc/Data ☐ Equip/Tooling ☐ Handling/Pre ☐ Material ☐ Internal Transport ☐ Tribal Knowledge ☐ LOA ☐ Substation ☐ Past Expiry Date ☐ Misidentified ☐				Pressure/Forced ☐ Bending ☐ Centre Not Concentric ☐ Cracks ☐ Crimp/Kink/Ripple/Wave ☐ Cuffs ☐ Crushing ☐ Heat Treat ☐ Wave/Twist in Tube ☐ Marks/Chatter ☐ Temperature/Cure ☐ Set-up ☐ BOM/Route ☐ Broken/Damage/Defect ☐ Inspection Incomplete/Unqualified ☐ Contamination ☐ Countersink ☐ Cut Too Short ☐ Instructions Incomplete/Unclear ☐ Drill Holes ☐ Power Loss/Surge ☐ Folio/Program ☐ Grain ☐ Weld ☐ Wrong Stock Pulled ☐ Out of Sequence ☐ Off-set ☒ Mislabeled ☐ Fit/Function ☐ Misaligned/off center ☐ Positioned Wrong ☐ Outside Dimensions ☐ Over/Under tolerance ☐ Part Incorrect ☐ Part Lost/Missing ☐ Part Moved ☐ Drawing ☐ Finish ☐ Misread ☐ Turning Sequence ☐							
OTHER: ☐											

Work Order ID 146207

May 11, 2016 12:39:15 PM

146207

Page 3

Item ID: D3695-3

Accept

N900040100

Setup Start

NS1

Revision ID:

Item Name: Stopper

Stop

NS2

Start Date: 5/20/2016 Start Qty: 10.00

10

Cust Item ID:

Required Date: 6/10/2016 Req'd Qty: 10.00

10

Customer:

Reference:

Approvals:

Process Plan:

Date:

Tooling:

Date:

Run

Start

NR1

QC:

Date:

SPC (Y/N):

Date:

Stop

NR2

Sequence ID/
Work Center ID

Operation
Description

Set Up/
Run Hours

Tool ID

Tool #

Plan
Code

Accept
Qty

Reject
Qty

Reject
Number

Insp.
Stamp

160

QC3- Inspect Part Finish

0.00

160

QC

Memo

0.00

Quality Control

(3)

DAS
38

JUN 07 2016

170

Identify as per dwg & Stock Location: 5t006

0.00

170

Packaging

Memo

0.00

Packaging

POSITIVE RECALL

EFFECTIVE 20/5/2016 AUTH SAD

RELEASED 42 DATE 16/7/17

DAS
6
9-89

JUN 09 2016

180

QC21- Final Inspection - Work Order Release

0.00

180

QC

Memo

0.00

Quality Control

16/02/08

MCS JUN 09 2016

Picklist Print

May 11, 2016 12:39:19 PM

Page 1

Work Order ID: 146207

146207

Parent Item: D3695-3

D3695-3

Parent Item Name: Stopper

Start Date: 5/20/2016

Required Date: 6/10/2016

Start Qty: 10.00

Required Qty: 10.00

Comments: IPP Rev:A 08-03-27 new issue DD verified by:JLM IPP rev:B
10.11.29 as per dwg revD DD verf:JLM

Component Item ID/ Item Name	Replacement Item ID	Mfg/ Purch	Bin Item	Primary Location	Last Location	Route Seq ID	Unit of Measure	Qty on Hand	Qty per Kit	Total Qty	Qty Issued	Date Issued	Status
M6061T6B2.500X03.50 0		Purchased		No		100	f	2.4030	0.37	3.894737			
										DAS			
										44			
										9.89		16-05-17	

M6061T6B2 500X03 500

6061-T6 Bar 2.50 x 3.50

Location	Loc Qty	Loc Code
MAT004	2.403	
m132772	0.3827	
m133265	0.6263	
m134158	1.394	


M134776

1.394'

2.58'

20160511

SA146207

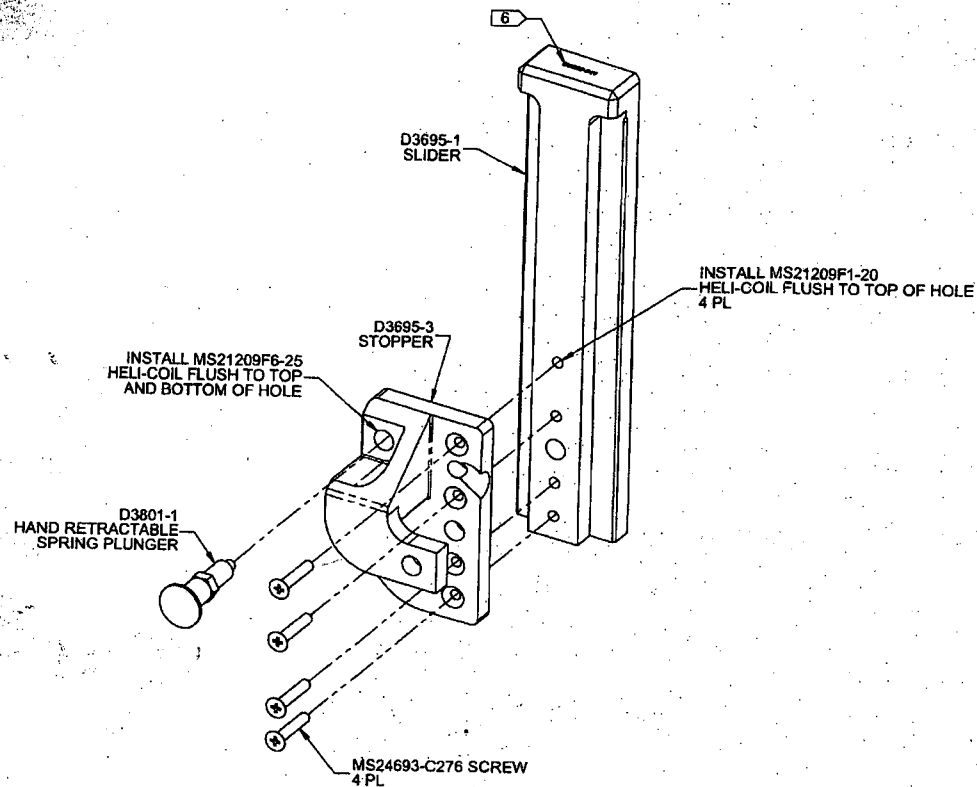**D3695-041 SLIDER ASSEMBLY****D3695-041 NOTES:**

- 1) MATERIAL: NONE
- 2) FINISH: NONE
- 3) TOLERANCES: PER DART QSI 018 UNLESS OTHERWISE NOTED
- 4) UNITS: INCHES UNLESS OTHERWISE NOTED
- 5) BREAK SHARP EDGES: N/A
- 6) IDENTIFICATION: IDENT P/N "D3695-041" PER QSI 044 6.1
- 7) WEIGHT: D3695-041 = 0.63 lbs

ITEM	QTY -041	P/N	DESCRIPTION
	X	D3695-041	SLIDER ASSEMBLY
1	1	D3695-1	SLIDER
2	1	D3695-3	STOPPER
3	1	D3801-1	HAND RETRACTABLE SPRING PLUNGER
4	4	MS21209F1-20	HELI-COIL, SCREW LOCKING (RED)
5	1	MS21209F6-25	HELI-COIL, SCREW LOCKING (RED)
6	4	MS24693-C276	SCREW



RELEASED
2012-07-16

E	ADDED R0.83 (ZN C8-3). REASON: PAR12-177.	MB	12.06.27
D	NOTE 6 UPDATED PER QSI. DIM 0.894 WAS 1.000 & 0.893 WAS 0.500 (ZN C8-2). REF NCR 10-324. CHAMFER ADDED TO D3695-1 (ZN C5-2).	JPH	10.08.24
C	UPDATED BOM TO CURRENT STANDARDS: REVISED ITEM 12 (ZN D3-1): DIMS 1.83 AND 1.075 WERE 1.81 AND 1.063. REASON: COMPENSATE FOR PAINT THICKNESS AND ELIMINATE RATTLE UPON ASSEMBLY.	MB	08.11.04
B	P/N D3808-1 WAS WIP-510 (ZN C7-1 AND D3-1) - REASON: PURCHASED PARTS NOW PROCURED THROUGH D3801 SPEC CONTROL DRAWING	MB	08.06.26
A	NEW ISSUE	MB	08.03.14
REV.	DESCRIPTION	BY	DATE
DESIGN			
DRAWN			
CHECKED			
MFG. APPR.			
APPROVED			
DE APPR.			
DATE	12.06.27		



DART AEROSPACE LTD
HAWKESBURY, ONTARIO, CANADA

DRAWING NO. **D3695** REV. E
TITLE **SLIDER ASSEMBLY** SCALE NTS
SHEET 1 OF 3

 COPYRIGHT © 2003 BY DART AEROSPACE LTD
THIS DOCUMENT IS PRIVATE AND CONFIDENTIAL AND IS SUPPLIED ON THE EXPRESS CONDITION THAT IT IS NOT TO BE USED FOR ANY PURPOSE OR COPIED OR REPRODUCED TO ANY OTHER PERSON WITHOUT WRITTEN PERMISSION FROM DART AEROSPACE LTD.

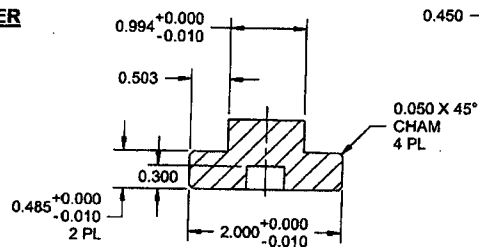

SECTION A-A

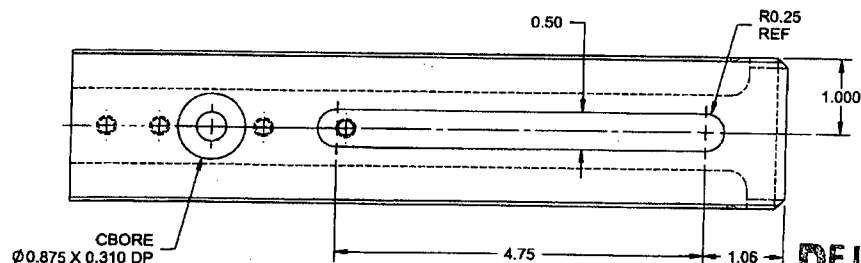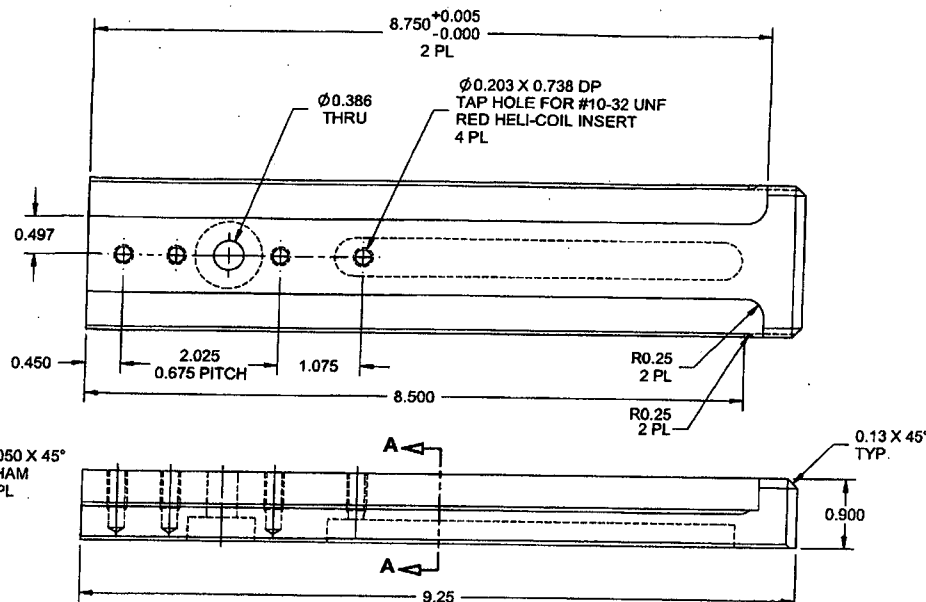

D3685-1 NOTES:


- D3695-1 NOTES:**
- 1) MATERIAL: 6061-T6 (OR 6061-T651/T-6510/T-6511/T-62) BAR
PER AMS-QQ-A-225/8 (OR AMS 4117/4128/4115/4116) OR
PER AMS-QQ-A-200/8 (OR AMS 4160)
(REF. DART SPEC. M6061T6B)
 - 2) FINISH: CHEMICAL CONVERSION COAT PER DART QSI 005 4.1
POWDER COAT GREY SANDTEX (4.3.5.6) PER DART
QSI 005 4.3 - MASK ALL HOLES AND UNHATCHED AREAS
 - 3) TOLERANCES: PER DART QSI 018 UNLESS OTHERWISE NOTED
 - 4) UNITS: INCHES UNLESS OTHERWISE NOTED
 - 5) BREAK SHARP EDGES: 0.005 TO 0.010 MAX
 - 6) IDENTIFICATION: NONE
 - 7) WEIGHT: 0.43lbs

RELEASE
2012-07-16

DESIGN		DART AEROSPACE LTD	
DRAWN		HAWKESBURY, ONTARIO, CANADA	
CHECKED		DRAWING NO.	REV. E
MFG. APPR.		D3695	SHEET 2 OF 3
APPROVED		TITLE	SCALE
DE APPR.		SLIDER ASSEMBLY	NTS
DATE	12.06.27 COPYRIGHT © 2008 BY DART AEROSPACE LTD THIS DOCUMENT IS PRIVATE AND CONFIDENTIAL AND IS MARKED UP ON THE EXPRESS UNDERSTANDING THAT IT IS NOT TO BE USED FOR ANY PURPOSE OR LOANED OR COMMUNICATED TO ANY OTHER PERSON WITHOUT		

MARC

HOLES ARE
0.015" OUT

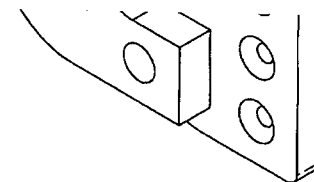



D3695-3 STOPPER

RELEASED
2012-07-16


D3695-3 NOTES:

- 1) MATERIAL: 6061-T6 (OR 6061-T651/-T6510/-T6511/-T62) BAR
PER AMS-QQ-A-225/8 (OR AMS 4117/4128/4115/4116) OR
PER AMS-QQ-A-200/8 (OR AMS 4160)
(REF. DART SPEC. M6061T6B)
- 2) FINISH: CHEMICAL CONVERSION COAT PER DART QSI 005 4.1
POWDER COAT GREY SANDEX (4.3.5.6) PER DART
QSI 005 4.3
- 3) TOLERANCES: PER DART QSI 018 UNLESS OTHERWISE NOTED
- 4) UNITS: INCHES UNLESS OTHERWISE NOTED
- 5) BREAK SHARP EDGES: 0.005 TO 0.010 MAX
- 6) IDENTIFICATION: NONE
- 7) WEIGHT: 0.19 lbs

DESIGN		DART AEROSPACE LTD	
DRAWN		HAWKESBURY, ONTARIO, CANADA	
CHECKED		DRAWING NO.	REV. E
MFG. APPR.		D3695	SHEET 3 OF 3
APPROVED		TITLE	SCALE
DE APPR.		SLIDER ASSEMBLY	NTS
DATE	12.06.27	COPYRIGHT © 2008 BY DART AEROSPACE LTD THIS DOCUMENT IS PRIVATE AND CONFIDENTIAL AND IS SUPPLIED ON THE EXPRESS CONDITION THAT IT IS NOT TO BE REPRODUCED FOR ANY PURPOSES OR COMMUNICATED TO ANY OTHER PERSON WITHOUT WRITTEN PERMISSION FROM DART AEROSPACE LTD.	

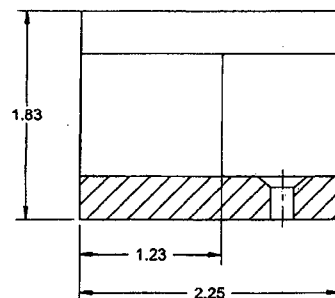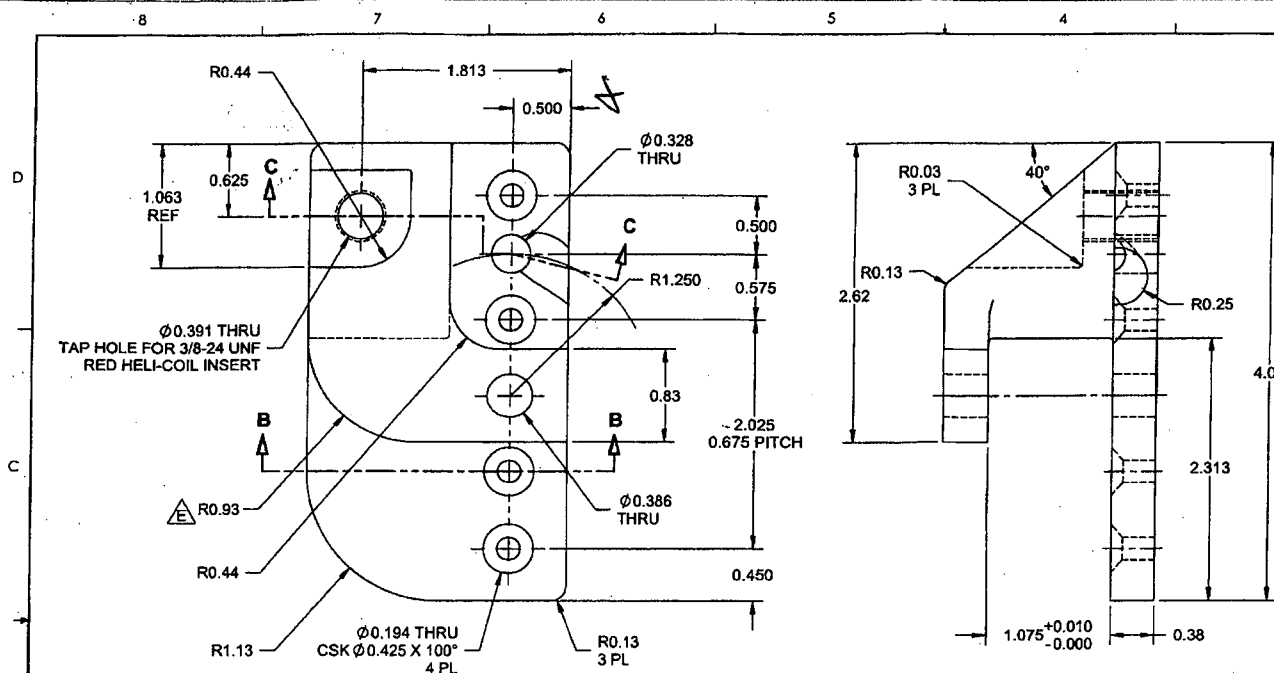

SECTION B-B

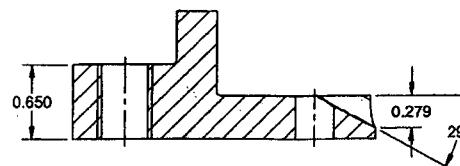

SECTION C-C

DART AEROSPACE LTD		Work Order:	146207
Description: Slider		Part Number:	D3695-3
Inspection Dwg: D3695 Rev: E		Page 1 of 1	

FIRST ARTICLE INSPECTION CHECKLIST

Drawing Dimension	Tolerance	Actual Dimension	Accept	Reject	Method of Inspection	Comments
0.625	+/-0.010	.625	/		Vern	FK-04
1.063	+/-0.010	1.061	/		H-G.	31006.
Ø0.391	+0.006/-0.001	.391	/		Vern	FK-04
Ø0.194	+0.005/-0.001	.194	/		"	"
Ø0.425 x 100°	+/-0.010 x 0.5°	.425 x 100°	/		"	"
Ø0.386	+0.006/-0.001	.387	/		"	"
0.450	+/-0.010	.451	/		"	"
2.025	+/-0.010	2.025	/		"	"
0.83	+/-0.010	.830	/		"	"
0.575	+/-0.010	.575	/		"	"
0.500	+/-0.010	.500	/		"	"
Ø0.328	+0.006/-0.001	.328	/		"	"
0.500	+/-0.010	.506	/		"	"
1.813	+/-0.010	1.821	/		"	"
2.62	+/-0.030	2.616	/		H-G.	31006.
1.075	+0.010/-0.000	1.079	/		Vern	FK-04
0.38	+/-0.030	.370	/		"	"
2.313	+/-0.010	2.312	/		"	"
4.00	+/-0.030	4.001	/		"	"
1.83	+/-0.030	1.836	/		"	"
1.23	+/-0.030	1.216	/		"	"
2.25	+/-0.030	2.250	/		"	"
0.650	+/-0.010	.653	/		"	"
0.279	+/-0.010	.279	/		"	"

Measured by: DAS 44 9-89		Audited by: DAS 14 9-89		Preliminary Approval:	
Date: 16-05-18		Date: 16/05/30		Date:	

Rev	Date	Change	Revised by	Approved
A	09.05.11	New Issue	KJ	
B	13.06.27	Dwg Rev updated	KJ	